




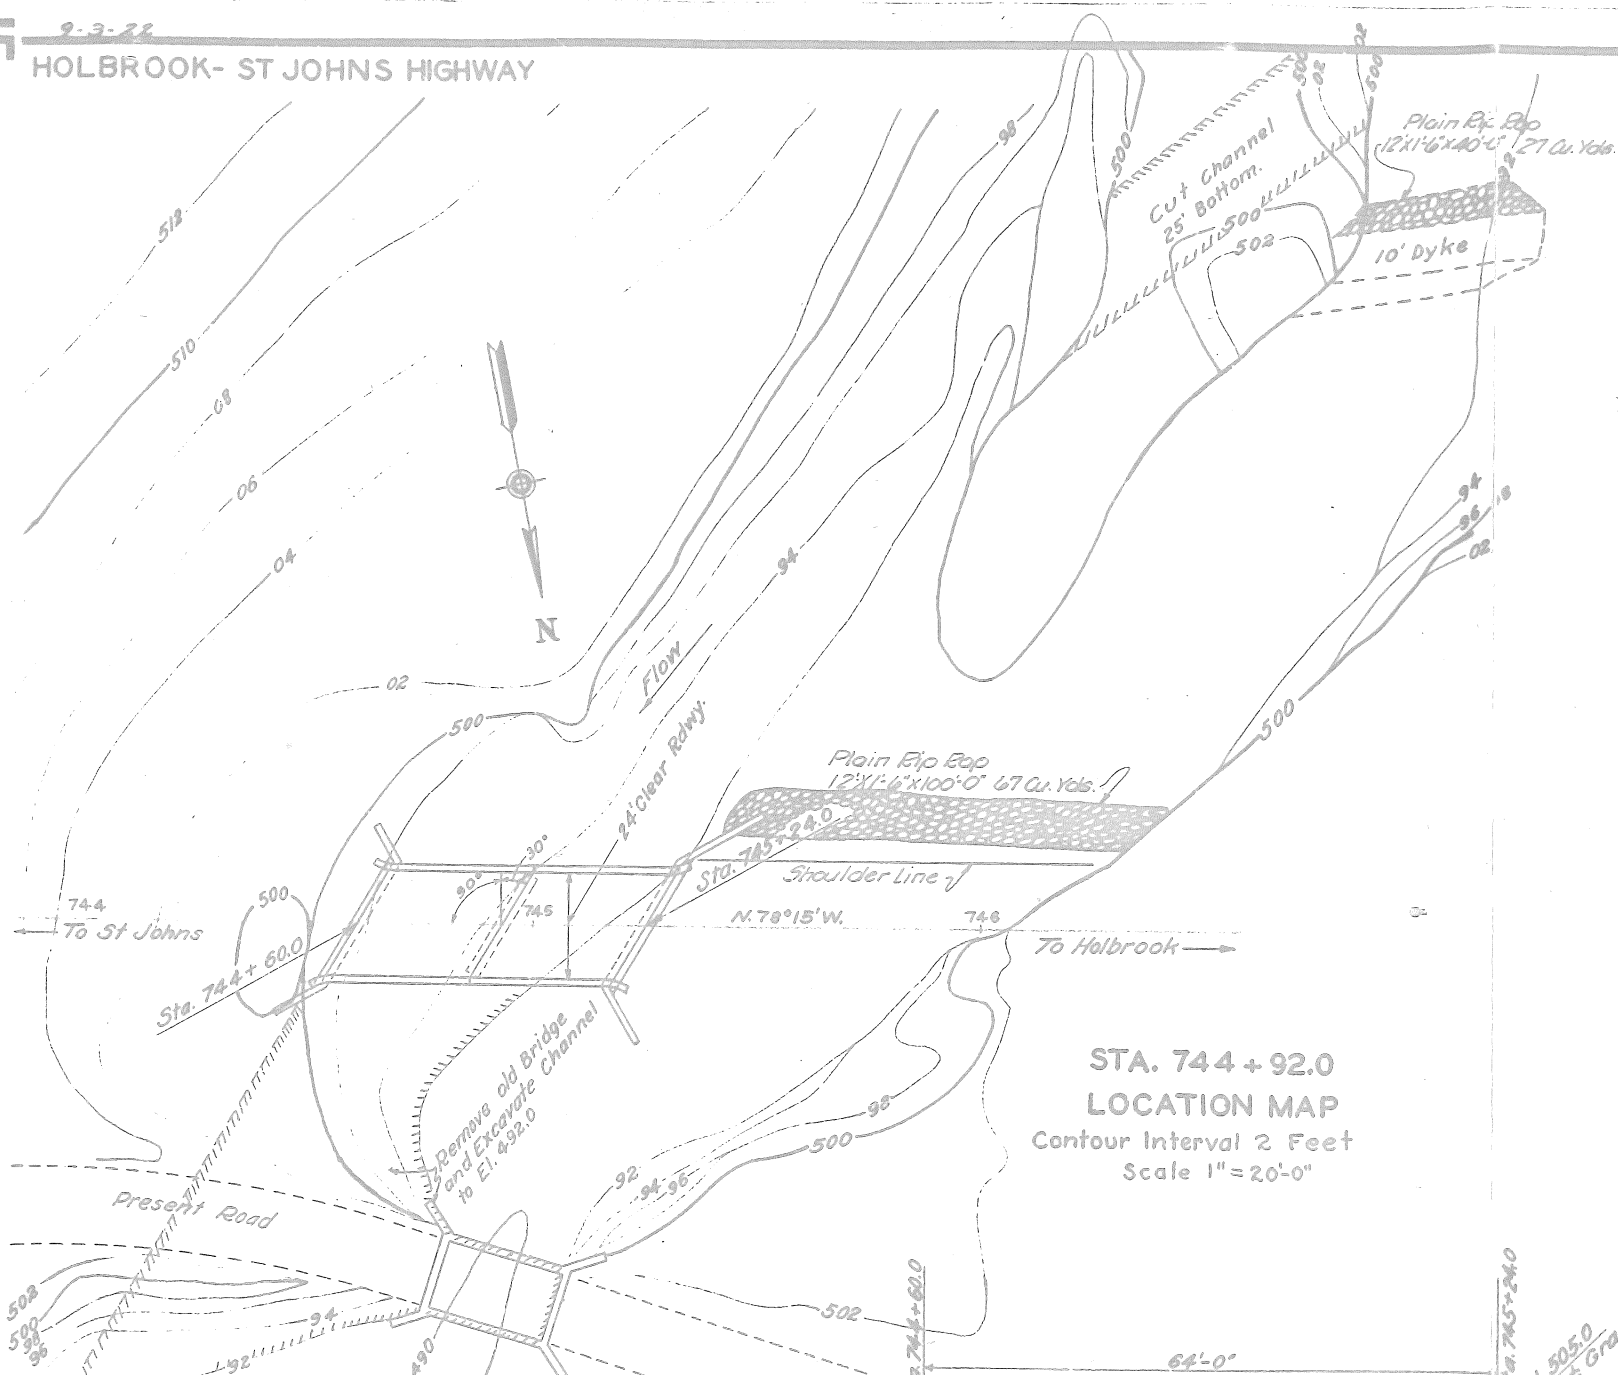


STA. 744+92.0
LOCATION MAP
Contour Interval 2 Feet
Scale 1"=20'-0"

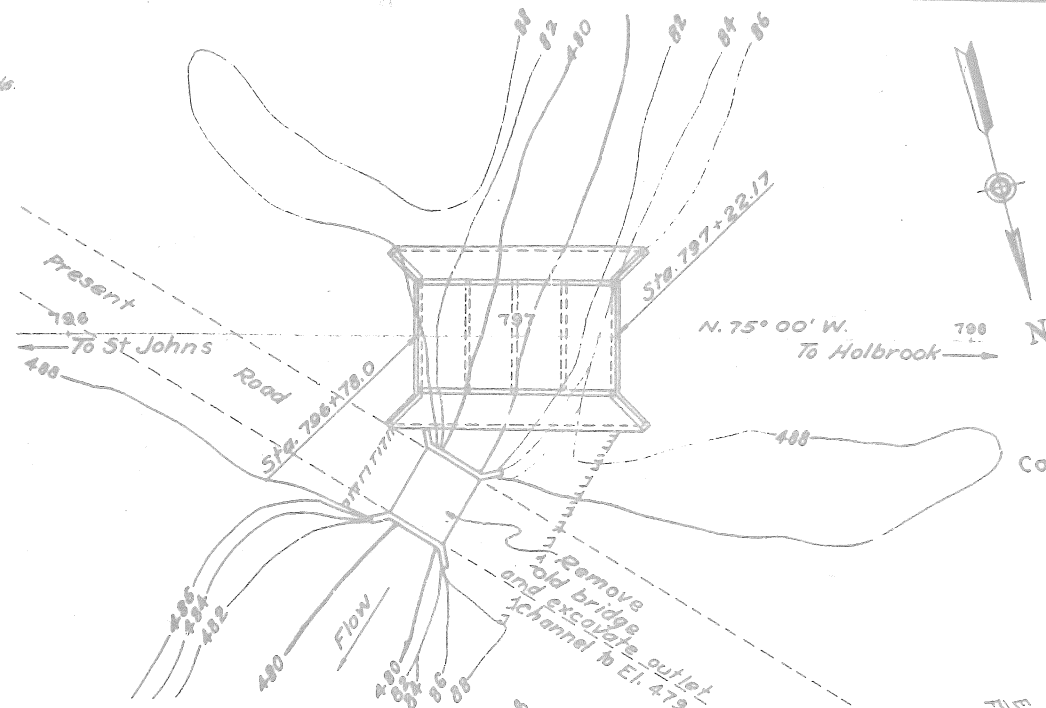

STA. 797+00.08
LOCATION MAP
Contour Interval 2 Feet
Scale 1"=20'-0"

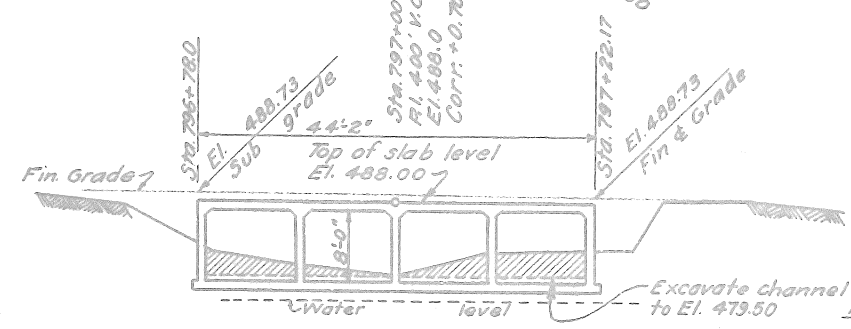

SECTION ON C
4 SPAN 10x8 BOX CULVERT
25'-6" LONG
Scale 1"=10'-0"

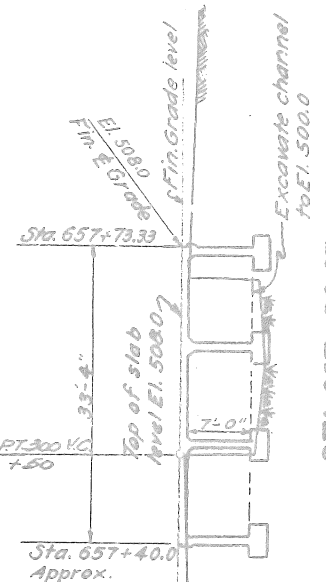

STA. 657+56.67
SECTION ON C
3 SPAN 10x7 BRIDGE CULVERT
25'-6" LONG
Scale 1"=10'-0"

QUANTITIES

BRIDGE AT STA. 744+92.0

ITEM	STANDARD NO.	SHEET NO.	CONC. CU.YDS.			REINF. STEEL LBS.	STRUCT. EXCAV. CU.YDS.	BRIDGE SEATS	
			A-A	A	B			Plain	Exp.
1-18' Abut.	0-142-18	16		82.51		5735	120		
1-11' "	0-142-11	15		34.10		1750	15		
1-11' Pier	C-3-5	17			36.39	495	15		
2-40' Decks	C-42-32	18		81.66		18100		8	8
1-Exp. Joint	"	13				1215			
Handrail	B-1-2	20	5.99			520			
Total			5.99	198.27	36.39	27735	180	8	8

Plain Rip Rap 94 Cu. Yds.

SECTION ON A
2-32'-4 GIRDER DECKS
1-18' & 1-11' ABUTMENTS
1-11' PIER
30° SKEW RT.
Scale 1"=10'-0"

QUANTITIES

BRIDGE AT STA. 797+00.08						
ITEM	STANDARD NO.	SHEET NO.	CONC. CU. YDS.	REIN. STEEL LBS.	STRENGTH EXCAV. CU. YDS.	BRIDGE SEATS
4-Sp. Box Culv.	Special	14	160.46	16445	140	

BRIDGE AT STA. 657+56.67						
ITEM	STANDARD NO.	SHEET NO.	CONC. CU. YDS.	REIN. STEEL LBS.	STRENGTH EXCAV. CU. YDS.	BRIDGE SEATS
3-Sp. Br. Culv.	0-10-10-3	13	67.62	6160	140	

PROPERTY OF
BRIDGE MAINTENANCE
STRUCTURE NO. 948
RTE, MP 180 309.11

ARIZONA HIGHWAY DEPARTMENT
BRIDGE PLANS
SPECIAL
PLAN & PROFILE BRIDGES
AT STATIONS
657+56.67 744+92.00 & 797+00.08

DESIGNED BY J.H.L. & L.E.M. 8-1930
CHECKED BY J.H.L. 9-1930
APPROVED BY J.H.L. 10-1930
BRIDGE ENG. J.H.L.