2. North West Dry-well location

1. North Dry-well Location

3. South West Dry-well Location

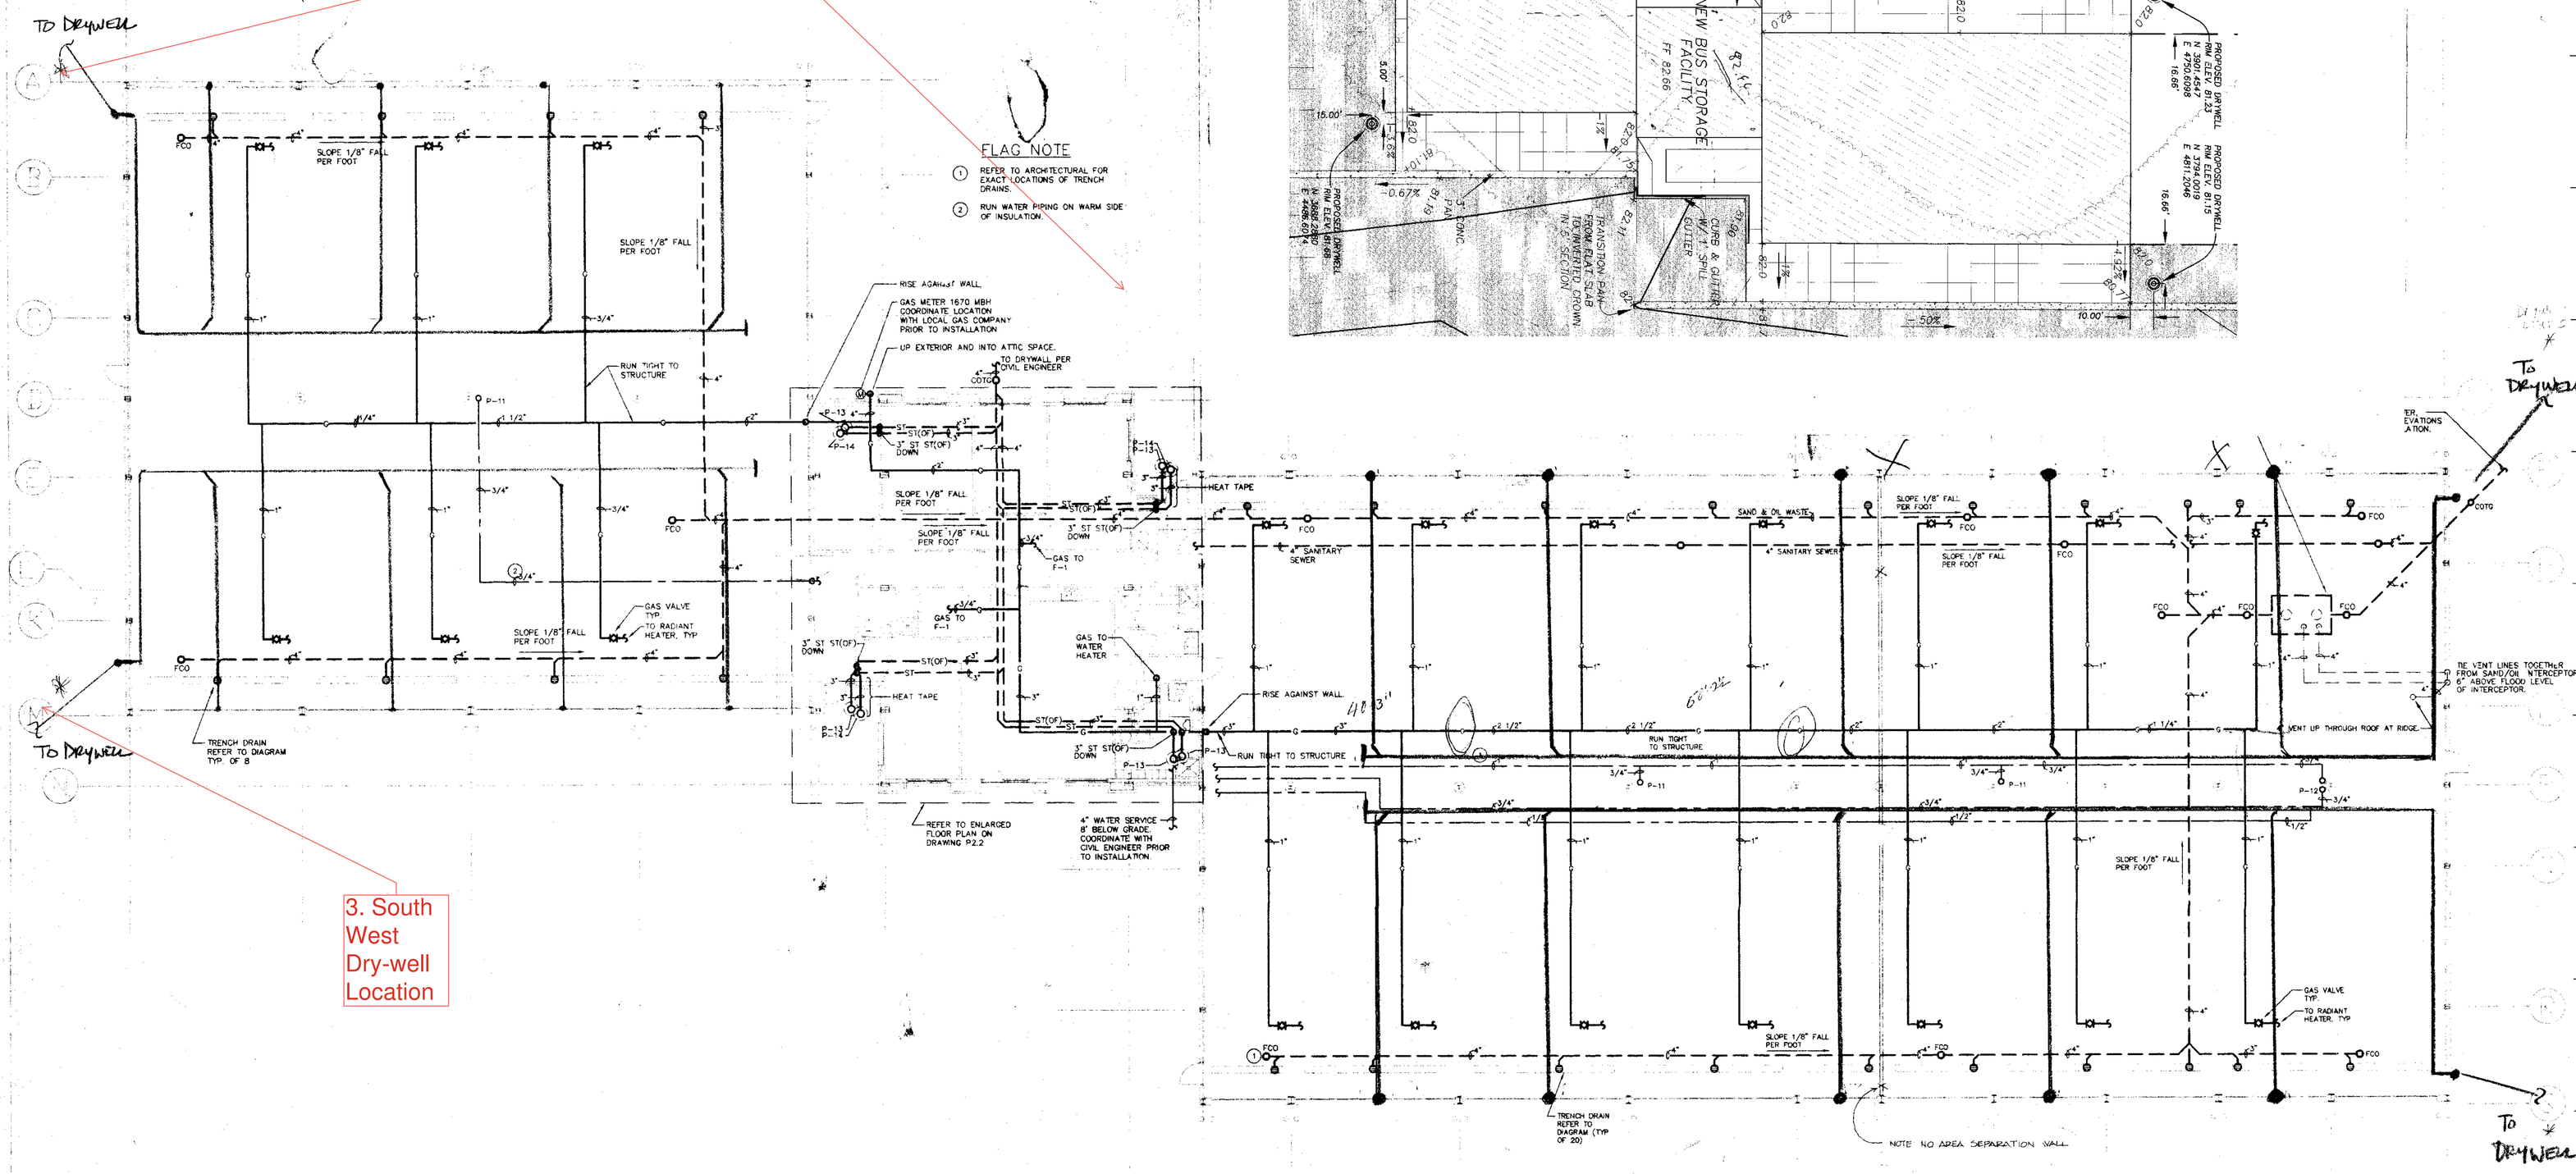

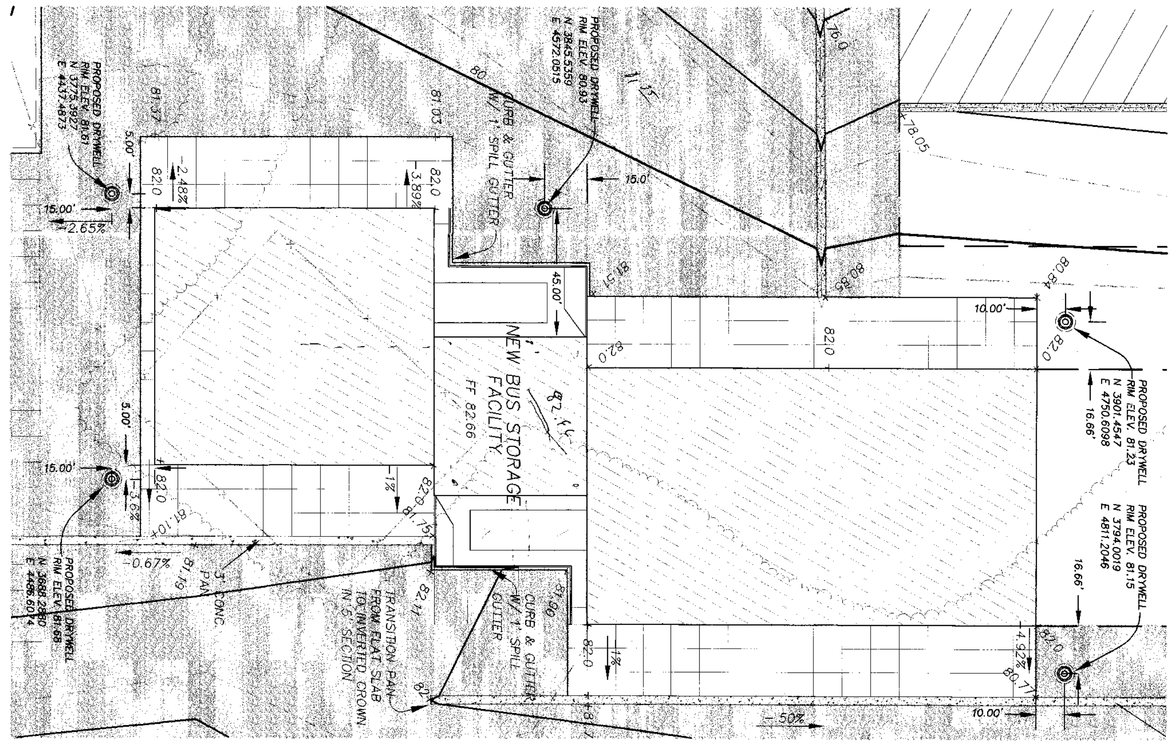

FLAG NOTE

1. REFER TO ARCHITECTURAL FOR EXACT LOCATIONS OF TRENCH DRAINS.
2. RUN WATER PIPING ON WARM SIDE OF INSULATION.

NOTATES ROOF DRAIN (TYPICAL 10 DRAINS) LARGE BARN
(TYPICAL 6 DRAINS) SMALL BARN

① PLUMBING FLOOR PLAN
1"=10'-0"

RECORD DWG'S

GUNNISON ASSOCIATES, P.C.
ARCHITECTS
234 E. HOPKINS AVE. P.O. BOX FF ASPEN, COLORADO 81611 970-925-3383

YODER Engineering Consultants, Inc.
Mechanical / Electrical
VAIL, COLORADO
0048 East Beaver Creek Blvd. Suite 307 Beaver Creek Plaza, Avon, CO 81620 970-949-1191 Fax: 949-1859 303-949-1191 Denver Direct Line: 825-0083

SUMMIT COUNTY
TRANSIT FACILITIES

SUMMIT COUNTY, COLORADO

No.	Description	Date
	Issues / Revisions: CONSTRUCTION DOCUMENTS	07/12/95
	ADDENDUM #1	07/29/95

NORTH

PLUMBING FLOOR PLAN

Drawn: TJF
Checked: SHB
Approved: YEC

Sheet No. P2.1

copyright, gaudi gunnison & associates, p.c. '95